


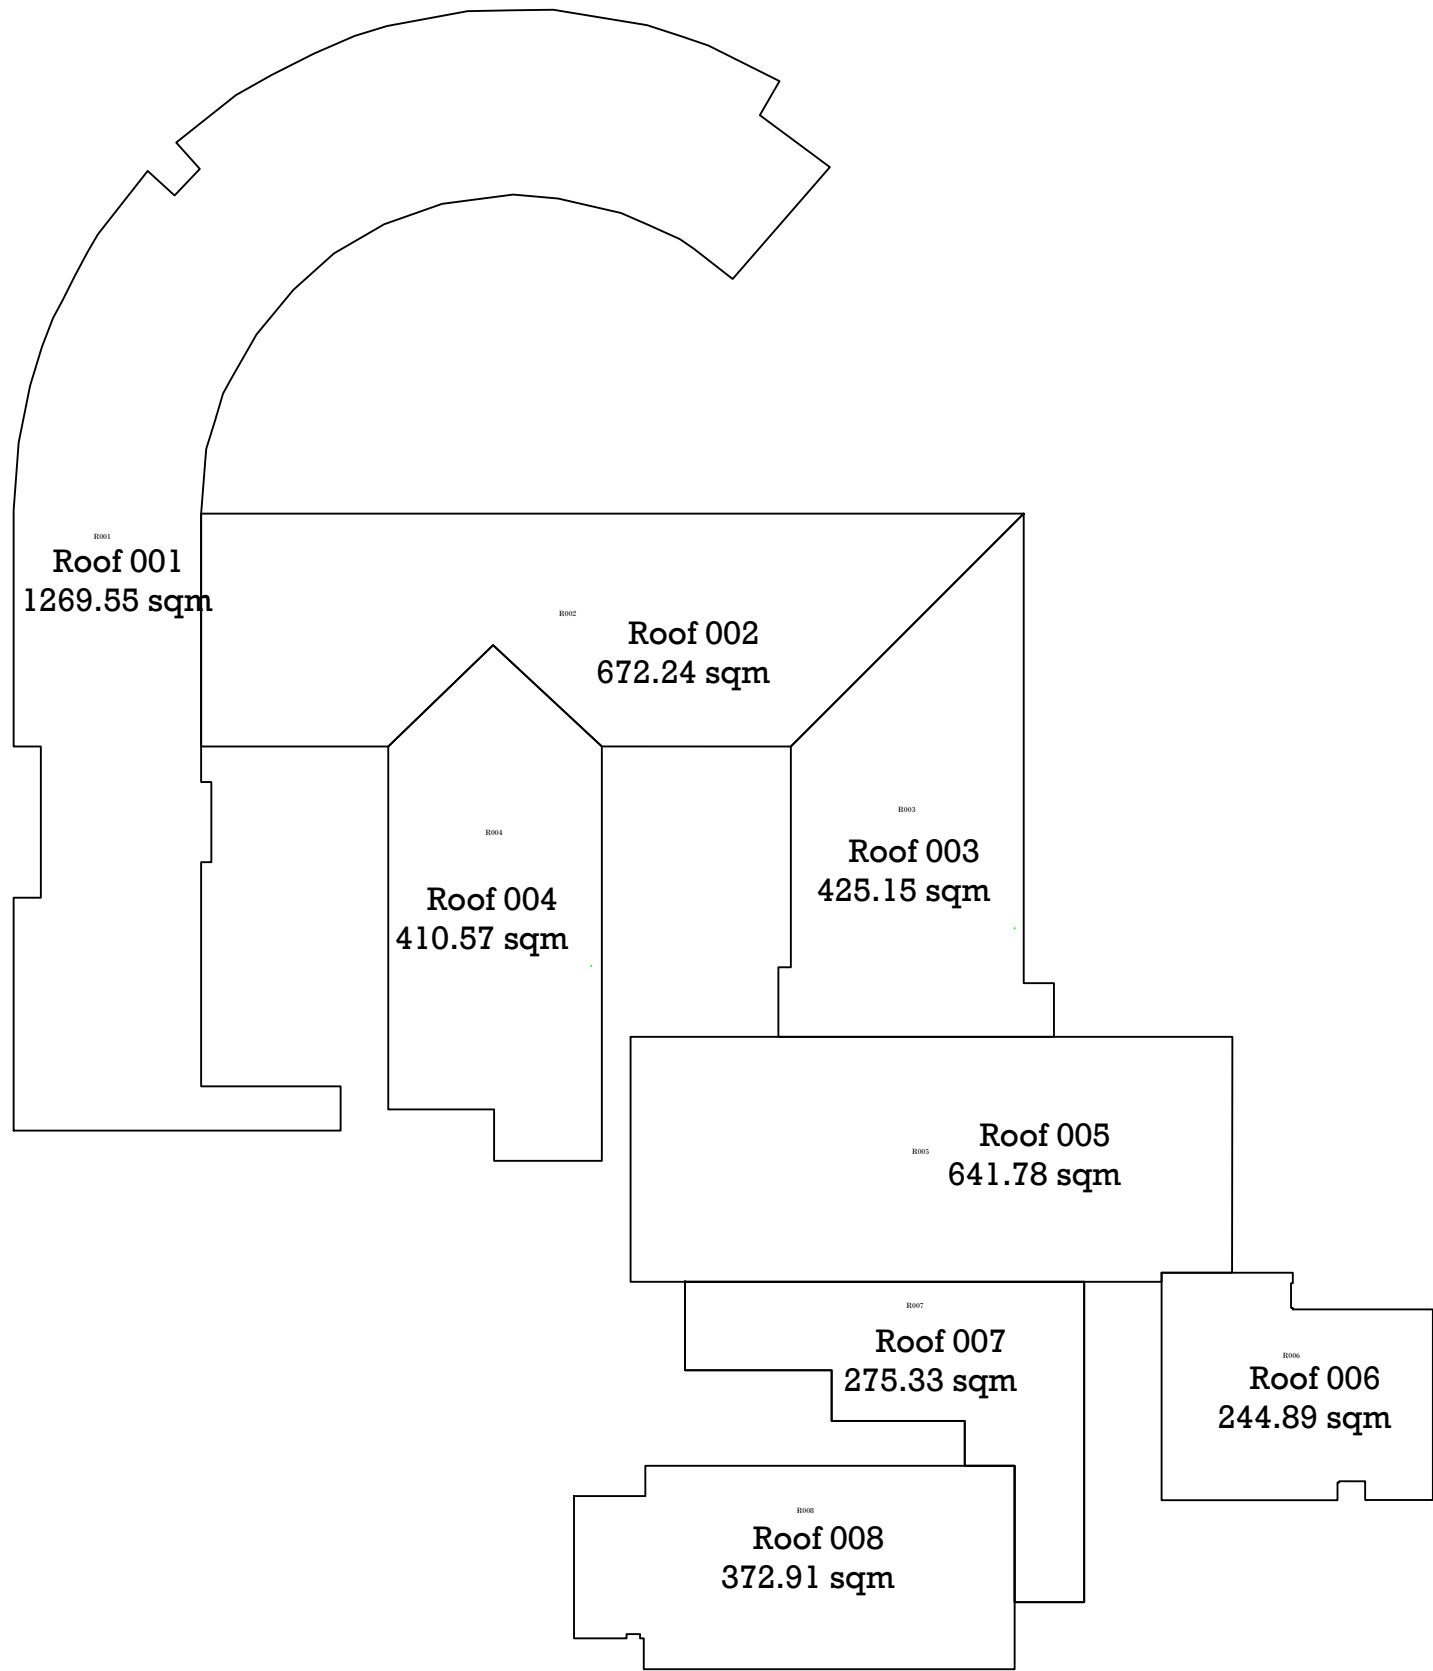

East Ayrshire Council
Safer Communities
Facilities and Property Maintenance
Opera House
8 John Finnie Street
Kilmarnock
stewart.finlay@east-ayrshire.gov.uk
Tel.01563 50-3456

Project/Location	8216 Patna & St Xaviers Campus Site Carnshalloch Avenue Patna KA6 7NP
Drawing Title	ROOFING PLAN AS BUILT SURVEY

Scale 1:500
Date February 2018